
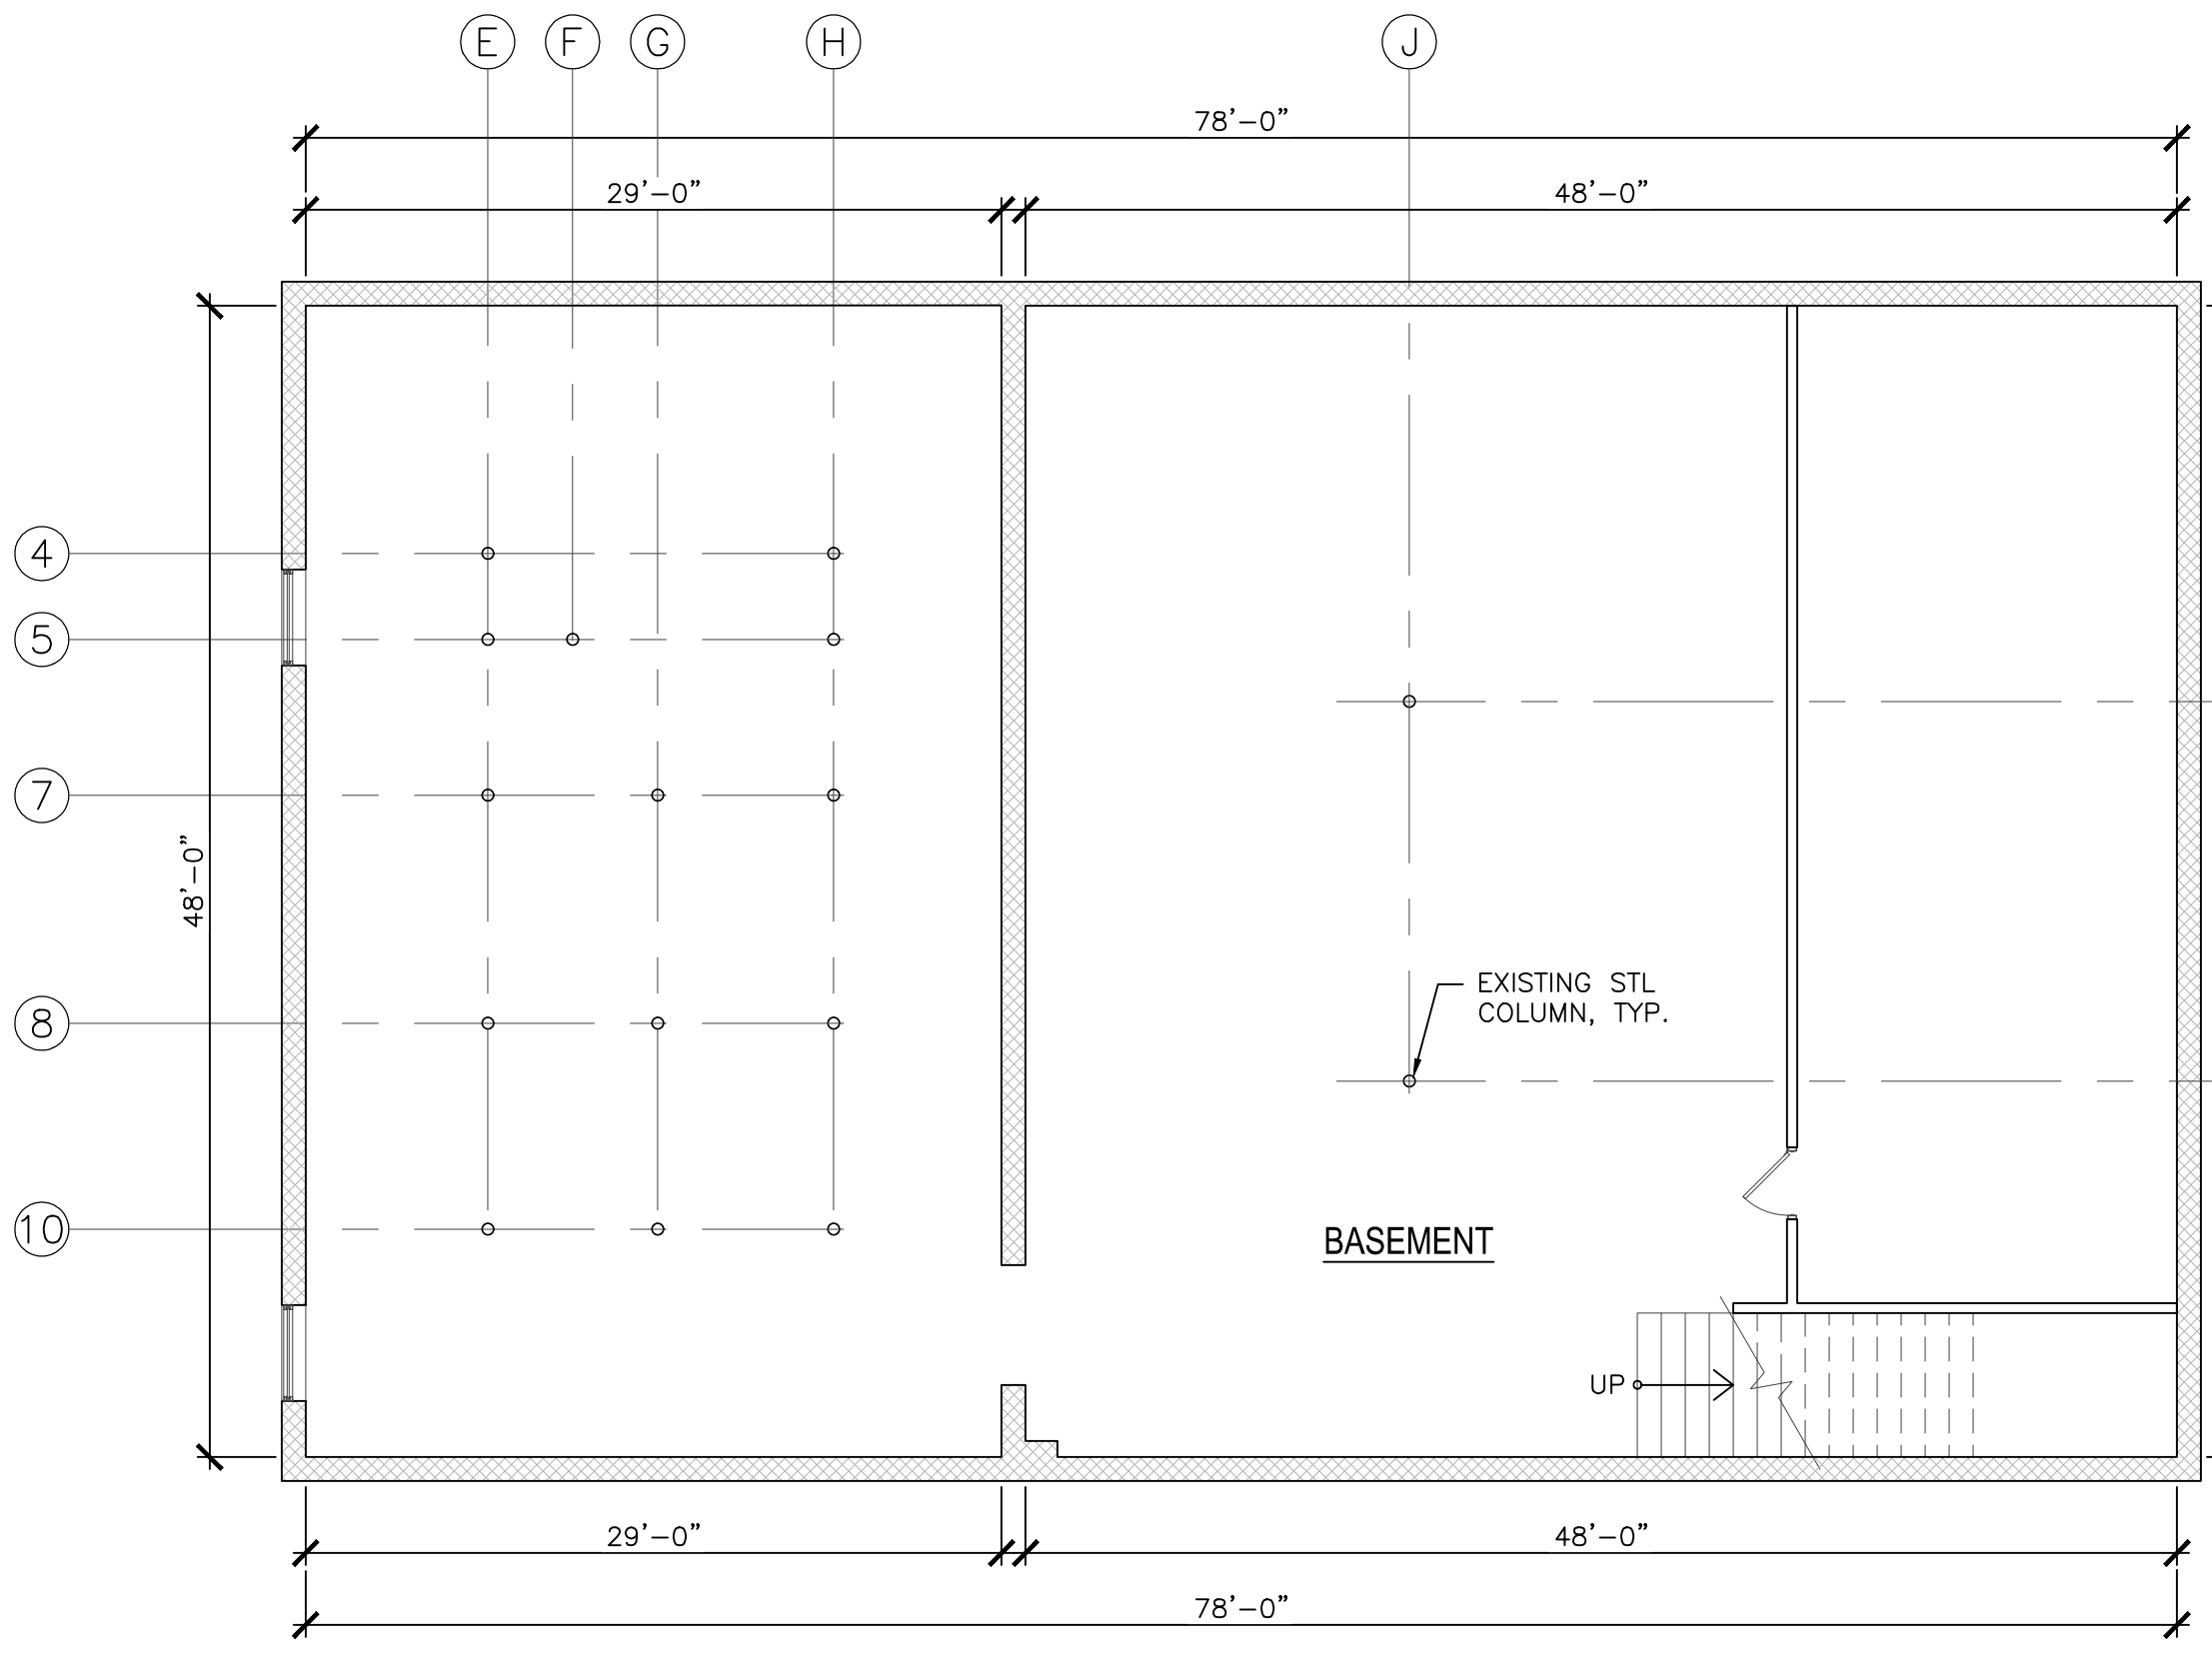


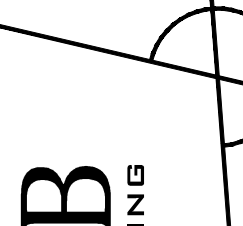

1 AS-BUILT MAIN LEVEL FLOOR PLAN
EX.1 SCALE: 1/8" = 1'-0"

DRAWINGS, DOCUMENTS, AND OTHER ITEMS PREPARED BY AYOUB ENGINEERING, INC. (AYOUB) ARE NOT INTENDED FOR RE-USE BY THE CLIENT, OR FOR OTHER PROJECTS. ANY MEDIA PREPARED BY AYOUB ARE SUBJECT TO USE ONLY BY EXPRESS WRITTEN PERMISSION BY AYOUB, AND IS NOT CONSIDERED THE CLIENT'S PROPERTY. IN THE EVENT THE CLIENT UTILIZES THIS INFORMATION WITHOUT WRITTEN PERMISSION, OR UTILIZES ANY OF THE WORK PRODUCT OR ANY INFORMATION SPECIFICALLY AUTHORIZED BY AYOUB, THE CLIENT DOES NOT ASSUME ANY OWNERSHIP AND AGREES TO DEFEND, INDEMNIFY AND HOLD AYOUB HARMLESS FOR ANY DAMAGES OR CLAIMS THAT MAY ARISE AS A RESULT OF RE-USE.

[illegible]

AYOUB
ENGINEERING

ENGINEERS & ARCHITECTS

CORPORATE OFFICE:

414 BENEFIT STREET
PAWTUCKET, RHODE ISLAND 02861
401-728-5535

PREPARED FOR GASPEE REAL ESTATE PARTNERS EAST GREENWICH, RI		PROJECT ADDRESS PROVIDENCE, RI 253 GEORGIA AVENUE	SHEET DESCRIPTION AS-BUILT FLOOR PLAN
PROJECT NO. 5044.121			
SCALE: AS NOTED DRAWN BY: MV DATE: 04/20/2021	SHEET NO. EX.1		